


NOTES

- 1 ALL CEILING HEIGHTS GIVEN ARE ABOVE FINISHED AND / OR RAISED FLOOR
- 2 SEE A.8.1 FOR BUILDING STANDARD CEILING DETAILS, NOTES AND METHODS OF INSTALLATION, NO EXCEPTIONS TO THESE STANDARDS ALLOWED.
- 3 DELETED
- 4 DELETED
- 5 'SMOKERS' EXHAUST FAN / GRILLE: REFER TO MECHANICAL DWGS. - SHEET M-2 FOR ADDITIONAL INFORMATION.
- 6 ALL SUSPENDED INDIRECT LIGHTING LENGTHS ARE NOMINAL - VERIFY ACTUAL
- 7 CEILING HEIGHT IS ABOVE FINISH FLOOR COORDINATE WITH RAISED FLOOR OR SLAB.
- 8 STARTING LINE OF ACOUSTIC TILE CEILING
- 9 ALL ANCHORS ATTACHED TO SLAB/METAL DECK ABOVE TO BE ANCHORED TO THE TOP OF THE METAL DECK RIB - TYPICAL.
- 10 FOR HEIGHT & SPACING OF WALL SCONCES SEE ELEVATIONS SHEET A6-SW

- 2'x2' ACOUSTIC CEILING TILE (SEE FINISH SCHEDULE A7.0)
- SUSPENDED INDIRECT LIGHTING - LEDALITE BEAM I 2 LAMP T8, 277V;
- WALL SCONCE - VISA LIGHTING COLONNADE CB3550 - BA WALLMOUNTED 277V, 1-27W FLUORESCENT
- SURFACE MOUNTED CEILING FIXTURE - LOUIS POULSER AJF-809 120V, NPF 2/13W/CF
- RECESSED FLUORESCENT LIGHTING - 2'x4' 3LAMP, 18 CELL PARABOLIC ENERGY EFFICIENT FLUORESCENT FIXTURE
- RECESSED FLUORESCENT LIGHTING - 1'x4' LAMP, 6 CELL PARABOLIC ENERGY EFFICIENT FLUORESCENT FIXTURE
- RECESSED FLUORESCENT LIGHTING - 2'x2' 2LAMP, 9 CELL PARABOLIC

REMAINING FIXTURES

	NOMINAL	ACTUAL
1	(9) 8'-0"	8' 3-3/8"
2	(15) 12'-0"	12' 3-7/16"
3	(0) 28'-0"	28' 6-15/16"
4	(4) 20'-0"	20' 5-3/16"
5	(0) 16'-0"	16' 5-1/8"
6	(4) 4'-0"	?

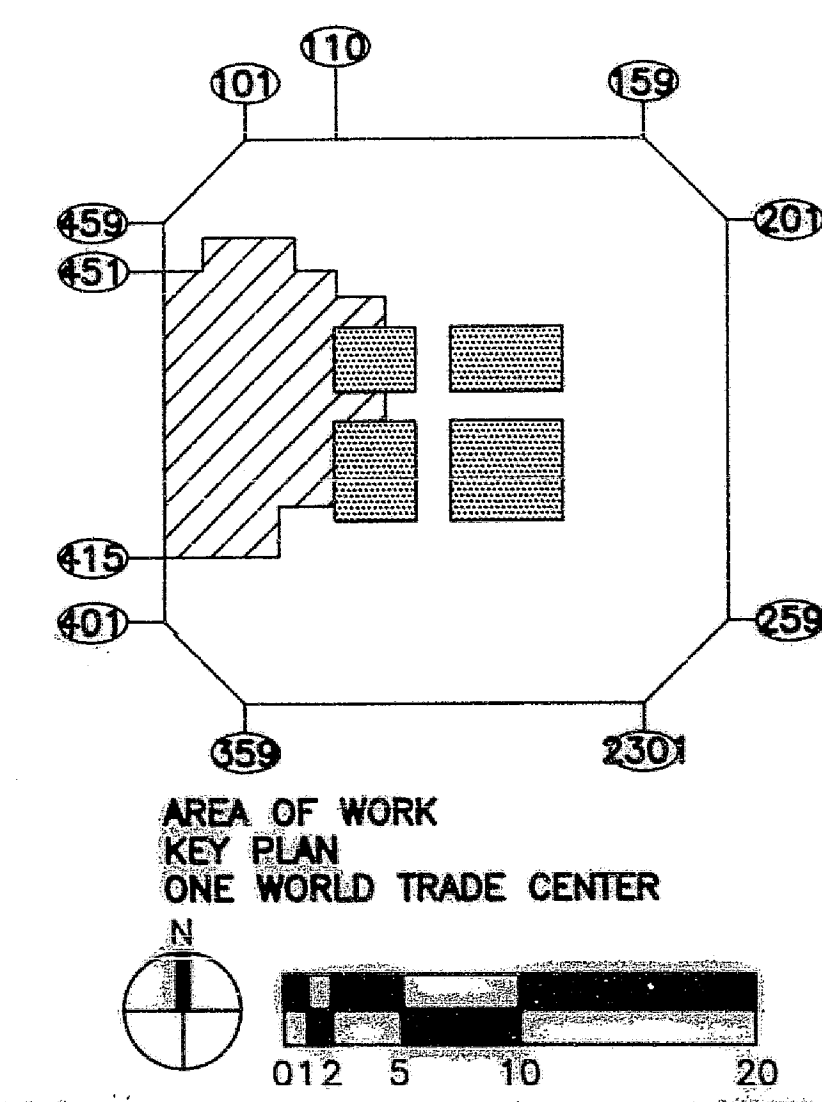

CANTOR FITZGERALD
 110 WALL STREET, NEW YORK, NY 10038
 FLOOR 105

WPG DESIGN GROUP
 ARCHITECTS
 INTERIOR DESIGNERS
 335 WEST 42ND STREET
 NEW YORK, NEW YORK 10018
 TEL: 212 693-1111
 FAX: 212 693-2222

Handwritten signature: J. G. ...
 J. G. ...
 GENERAL CONTRACTING
 CERTIFIED AS-BUILT

No.	Revision	Issued Record
2.8.94	REVISED PER PORT AUTHORITY OF NY & NJ COMMENTS	0 M S CM
2.15.94	REVISED PER CLIENT REQUEST	
5.16.94	REVISED PER PORT AUTHORITY OF NY & NJ COMMENTS AND TENANTS REQUESTS	
7.12.94	REVISED UPDATE	
9.20.94	REVISED AS PER PORT AUTHORITY OF NY & NJ COMMENTS	
5.20.95	REVISED AS PER PORT AUTHORITY OF NY & NJ COMMENTS	

Titles

REFLECTED CEILING PLAN

Scale 1/8"=1'-0"	Drawn By JP/HR
Project No. 93165-105	Date 7.7.94
	Dwg. No.

A4.NW
 FLOOR 105